

DETOUR PROPOSAL for SOUTHEAST REGION

Project No.: BOA # UES 1002 Highway (or Local Street Name): Silvernail Road Date: 4/17/2024
County: Waukesha
Project Location: Between Grandview Boulevard and Bluemound Road
Type of Work: Roadway Re-Alignment

Anticipated Dates that Detour will be in Effect: 30 calendars between July and August of 2025

Advanceable Project Year: N/A

Special Circumstances affecting Route or Schedule (i.e. community events, environmental concerns): N/A

Route to be detoured: Silvernail eastbound and westbound.

SUGGESTED DETOUR ROUTE: (Include detailed maps w/limits of construction shown in red and detour route shown in green) See attached detour route plan sheets.

Detour Route to be signed and signing maintained by: Contractor

BOA Project Manager: Andrew Trimble

Mead and Hunt Project Team Leader: Brian Veit

Design Consultant (If applicable): Mead and Hunt

SE REGION SECTION REVIEW: (Sign; date; circle Y or N at the right concerning comments and place comments, if any, on page 2)

	Signature	Date	Comments Included?
1. TU 2, TRAFFIC OPERATIONS	<i>Karen Martens</i>	4/18/24	☒ N
2. MAINTENANCE UNIT, HIGHWAYS	<i>Jason Jilling</i>	5/1/24	Y ☒
3. PROJECTS TEAM * {EX S3, N1,}			Y N
4. TU 1, SIGNAL OPERATIONS **	<i>Jarrett Gates</i>	4/18/2024	☒ N

* If consultant or local government prepared Detour Proposal

** If detour impacts a signalized intersection

5. MUNICIPALITY(IES) affected by detour (Insert name of municipality at left; sign; date; circle Y or N at the right concerning comments and place comments, if any, on page 2).

5.1 WAUKESHA COUNTY	<i>M. Veit</i>	5/2/2024	☒ N
5.2			Y N
5.3			Y N

APPROVED BY MAINTAINING AUTHORITY:

Name of Authority: _____ Signature: _____ Date: _____

Written approval for this use shall be obtained from the Maintaining Authority by the Projects Team, Project Manager (for in house projects) or the design consulting firm (for consultant design projects).

Southeast Region Office Use Only

Date returned to SE Region Traffic Operations: _____ Signature: _____

SUGGESTED DETOUR ROUTE APPROVED

ALTERNATE DETOUR ROUTE:

SECTION REVIEW COMMENTS:

1. TRAFFIC UNIT 2, TRAFFIC OPERATIONS:

Project ID 1060-47-70 resurfacing project is scheduled on I-94 for 2024 from STH 83 to STH 16.

2. MAINTENANCE UNIT 1, HIGHWAYS:

3. PROJECT TEAM _____ (If applicable):

4. TRAFFIC UNIT 1, SIGNALS OPERATIONS (If applicable):

Possible timing changes at IH 94 & STH 164 and IH 94 & CTH T signals. Contact the signal operations Red Phone (414-750-2605) or Jarrett Gates (262-548-5894) prior to implementing this detour route.

5.1 LOCAL MAINTAINING AUTHORITY (If applicable):

Timing changes may be needed at the intersection of CTH J/Pewaukee Rd and CTH JJ/ Bluemound Rd. Please contact Matthew Cowap (262-548-7748) or Steven Schultz (262-548-9129) before implementing this detour route.

5.2 LOCAL MAINTAINING AUTHORITY (If applicable):

5.3 LOCAL MAINTAINING AUTHORITY (If applicable):

X:\23090900\120630_03\TECH\G-060 DETOUR PLAN.DWG
4/17/2024 9:43:54 AM



**WAUKESHA COUNTY AIRPORT
SILVERNAIL ROAD REALIGNMENT**

2525 AVIATION RD
WAUKESHA, WI 53188

ISSUED:
4/19/2024 ADDENDUM #1

3/22/2024 BID SET

BOA NO.: UES 1002
DATE: MARCH 22, 2024
DESIGNED BY: BTB
DRAWN BY: DAY
CHECKED BY: BWV
DO NOT SCALE DRAWINGS

SHEET CONTENTS
DETOUR PLAN
OVERVIEW

SHEET NO.

G-060

X:\2309090\120630_03\TECH\CAD\G-060 DETOUR PLAN.DWG
4/17/2024 9:43:59 AM



**WAUKESHA COUNTY AIRPORT
SILVERNAIL ROAD REALIGNMENT**

2525 AVIATION RD
WAUKESHA, WI 53188

ISSUED:
4/19/2024 ADDENDUM #1

3/22/2024 BID SET

BOA NO.: UES 1002
DATE: MARCH 22, 2024
DESIGNED BY: BTB
DRAWN BY: DAY
CHECKED BY: BWV
DO NOT SCALE DRAWINGS

SHEET CONTENTS
DETOUR PLAN
BLOWUP 1

SHEET NO.

G-061

X:\23090900\120630_03\TECH\CAD\G-060 DETOUR PLAN.DWG
4/17/2024 9:44:04 AM



**WAUKESHA COUNTY AIRPORT
SILVERNAIL ROAD REALIGNMENT**
2525 AVIATION RD
WAUKESHA, WI 53188

ISSUED:
4/19/2024 ADDENDUM #1

3/22/2024 BID SET

BOA NO.: UES 1002
DATE: MARCH 22, 2024
DESIGNED BY: BTB
DRAWN BY: DAY
CHECKED BY: BWV
DO NOT SCALE DRAWINGS

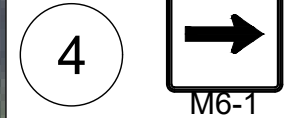
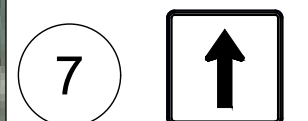
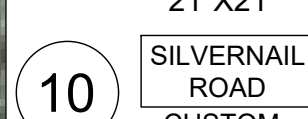
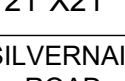
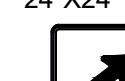
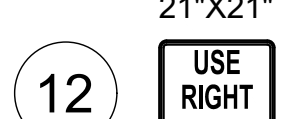
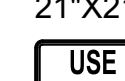
SHEET CONTENTS
DETOUR PLAN
BLOWUP 2

SHEET NO.

G-062

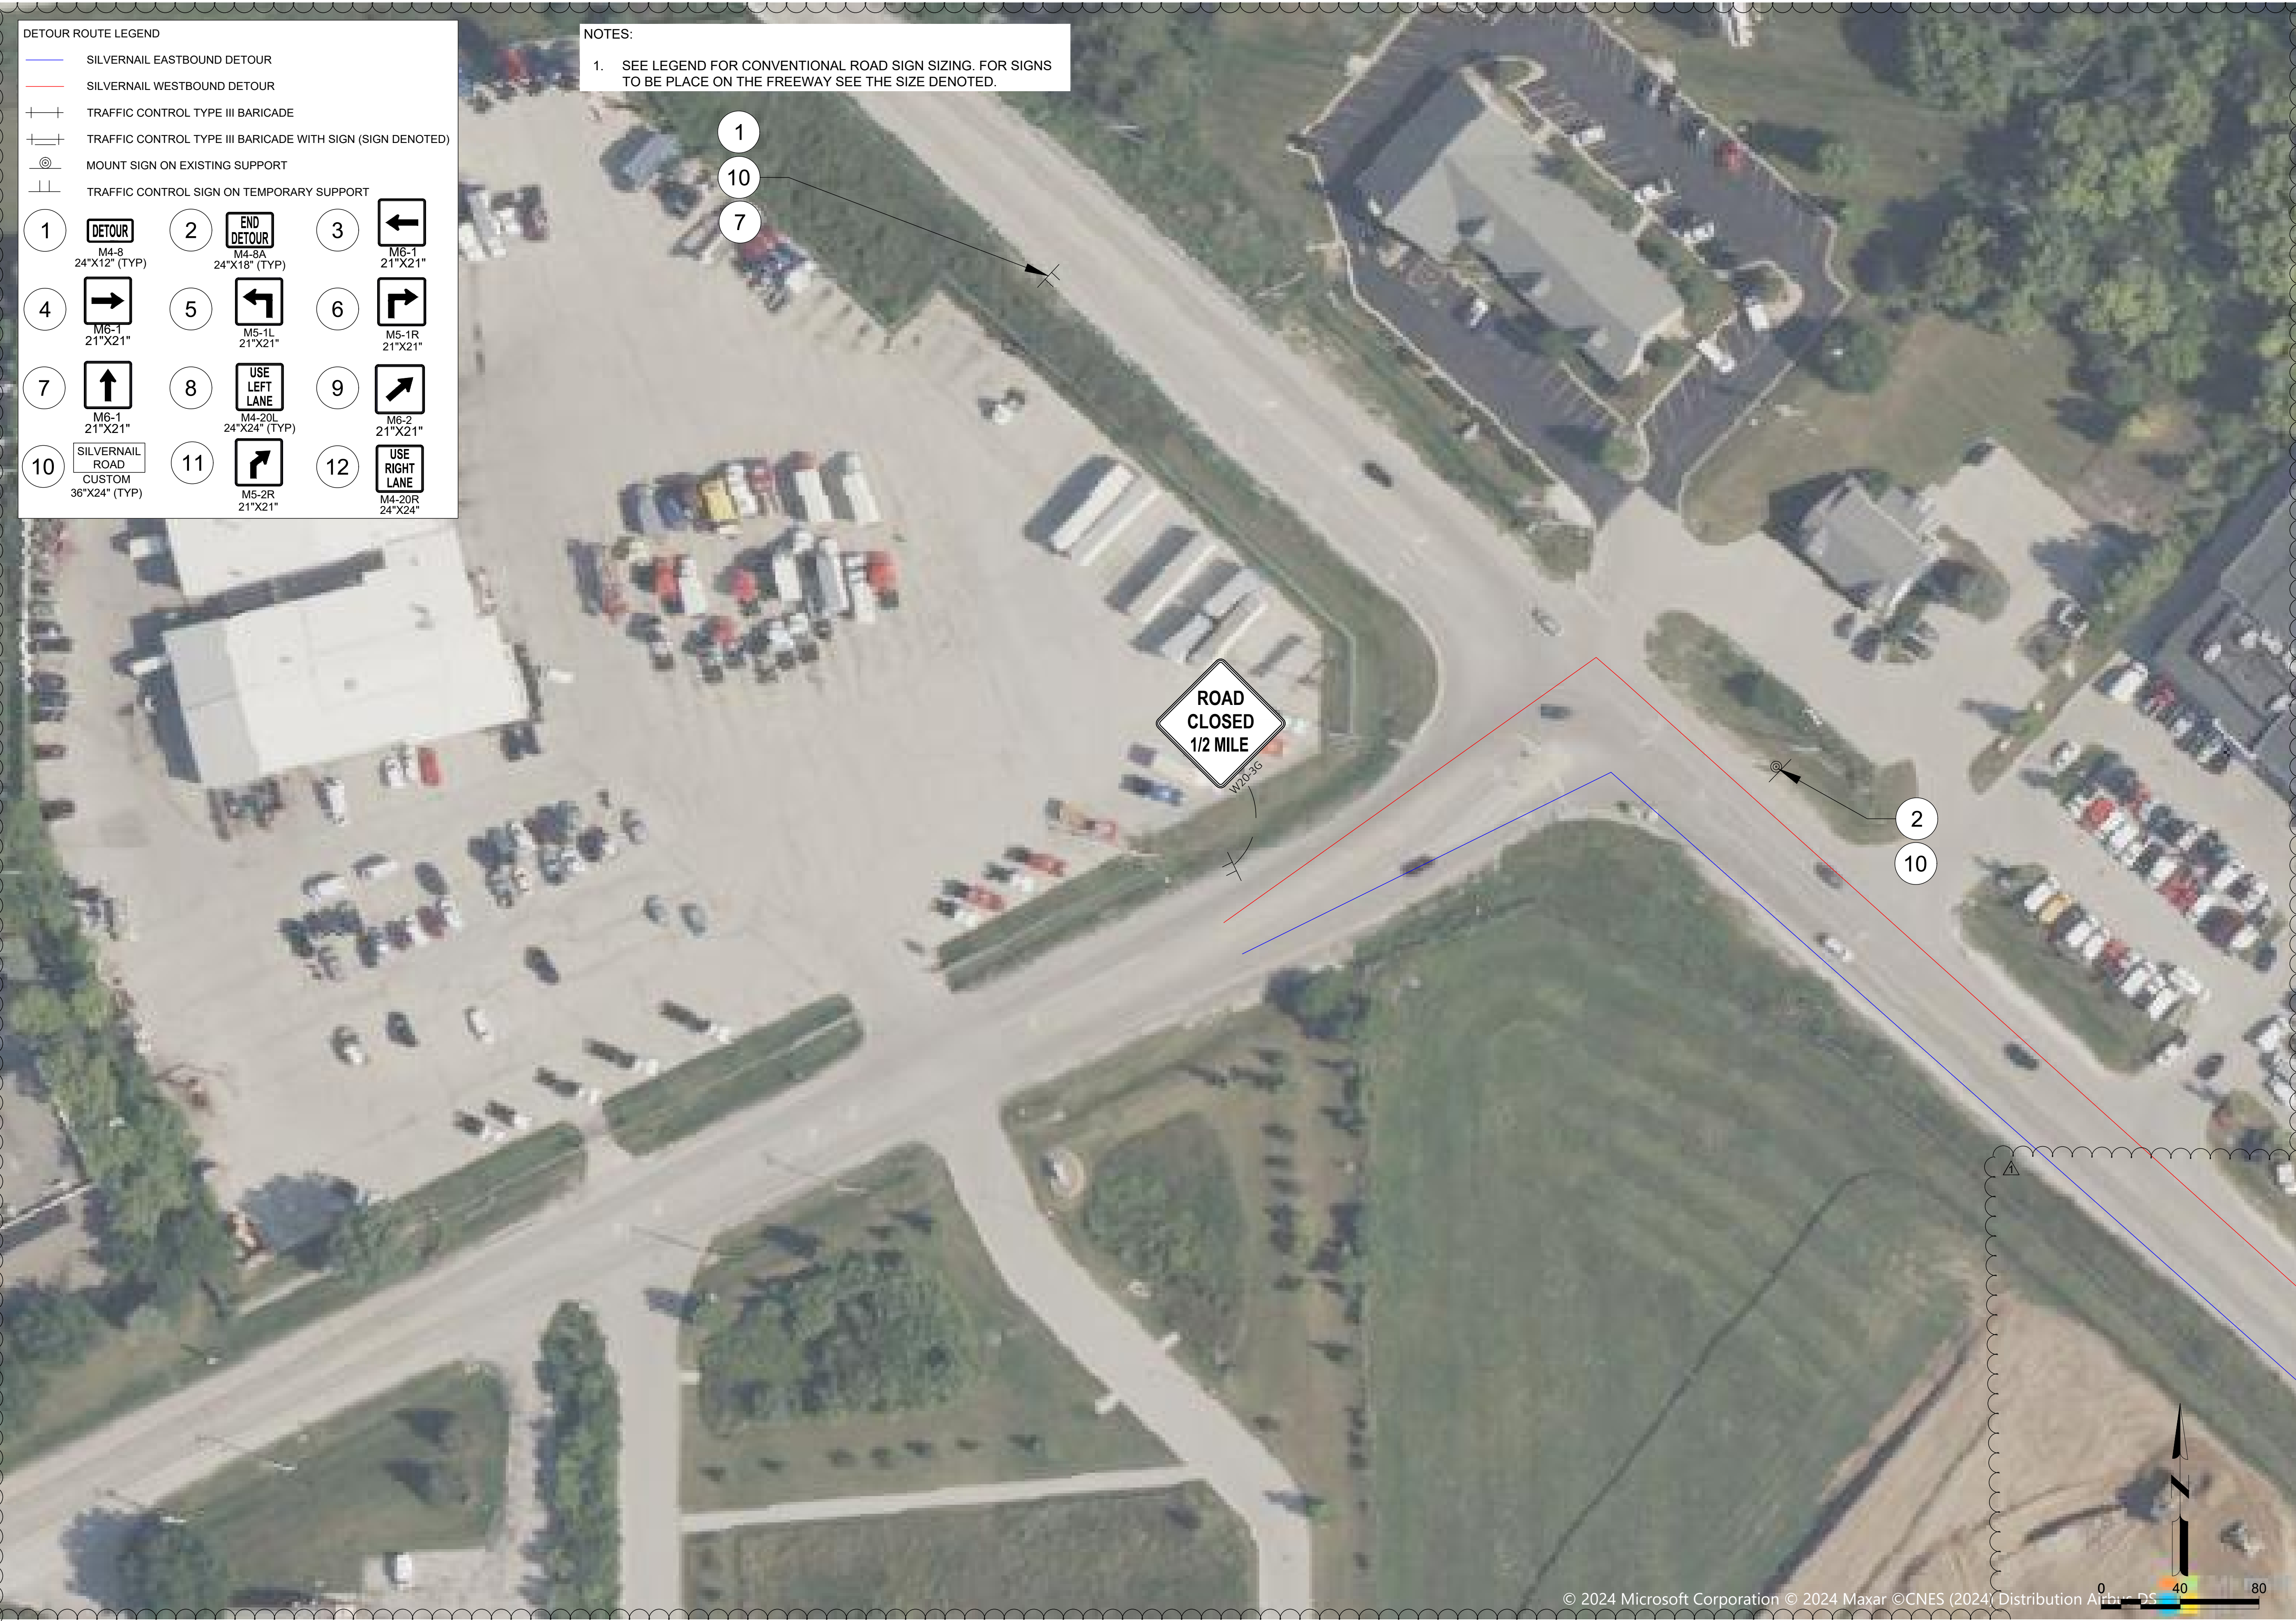
X:\2309990\120630_03\TECH\CAD\G-060 DETOUR PLAN.DWG
4/17/2024 9:44:09 AM

DETOUR ROUTE LEGEND

	SILVERNAIL EASTBOUND DETOUR
	SILVERNAIL WESTBOUND DETOUR
	TRAFFIC CONTROL TYPE III BARICADE
	TRAFFIC CONTROL TYPE III BARICADE WITH SIGN (SIGN DENOTED)
	MOUNT SIGN ON EXISTING SUPPORT
	TRAFFIC CONTROL SIGN ON TEMPORARY SUPPORT
	1  M4-8 24"x12" (TYP)
	2  M4-8A 24"x18" (TYP)
	3  M6-1 21"x21"
	4  M6-1 21"x21"
	5  M5-1L 21"x21"
	6  M5-1R 21"x21"
	7  M6-1 21"x21"
	8  M4-20L 24"x24" (TYP)
	9  M6-2 21"x21"
	10  SILVERNAIL ROAD CUSTOM 36"x24" (TYP)
	11  M5-2R 21"x21"
	12  M4-20R 24"x24"

NOTES:

1. SEE LEGEND FOR CONVENTIONAL ROAD SIGN SIZING. FOR SIGNS TO BE PLACED ON THE FREEWAY SEE THE SIZE DENOTED.



Mead & Hunt
Mead and Hunt, Inc.
2440 Deming Way
Middleton, WI 53562
phone: 608-273-6380
meadhunt.com



**WAUKESHA COUNTY AIRPORT
SILVERNAIL ROAD REALIGNMENT**

2525 AVIATION RD
WAUKESHA, WI 53188

ISSUED:
4/19/2024 ADDENDUM #1

3/22/2024 BID SET

BOA NO.: UES 1002
DATE: MARCH 22, 2024
DESIGNED BY: BTB
DRAWN BY: DAY
CHECKED BY: BWV
DO NOT SCALE DRAWINGS

SHEET CONTENTS
DETOUR PLAN
BLOWUP 3

SHEET NO.

G-063